

**SYMBOL LEGEND:**  
(UNLESS OTHERWISE NOTED)



<b>DOORS &amp; WINDOWS</b>		<b>FIXTURES</b>	<b>MISCELLANIES</b>
= BATHROOM STALL	= SINGLE DOOR	= SINK	= CONC BOLLARD
= DOUBLE DOOR	= WINDOW	= TOILET	= SIGN
= DOUBLE SWINGING DOOR		= URINAL	

**ABBREVIATION LEGEND:**  
(UNLESS OTHERWISE NOTED)

CONC = CONCRETE  
ELEC = ELECTRICAL  
MOL = MORE OR LESS  
O.C. = ON CENTER  
W/ = WITH

**LINE LEGEND:**

= DOOR SWING	= MISCELLANIES FEATURE
= EXTERIOR WALL	= OVERHANG
= INTERIOR HALF-WALL	= OVERHEAD WALL/FEATURE
= INTERIOR WALL	

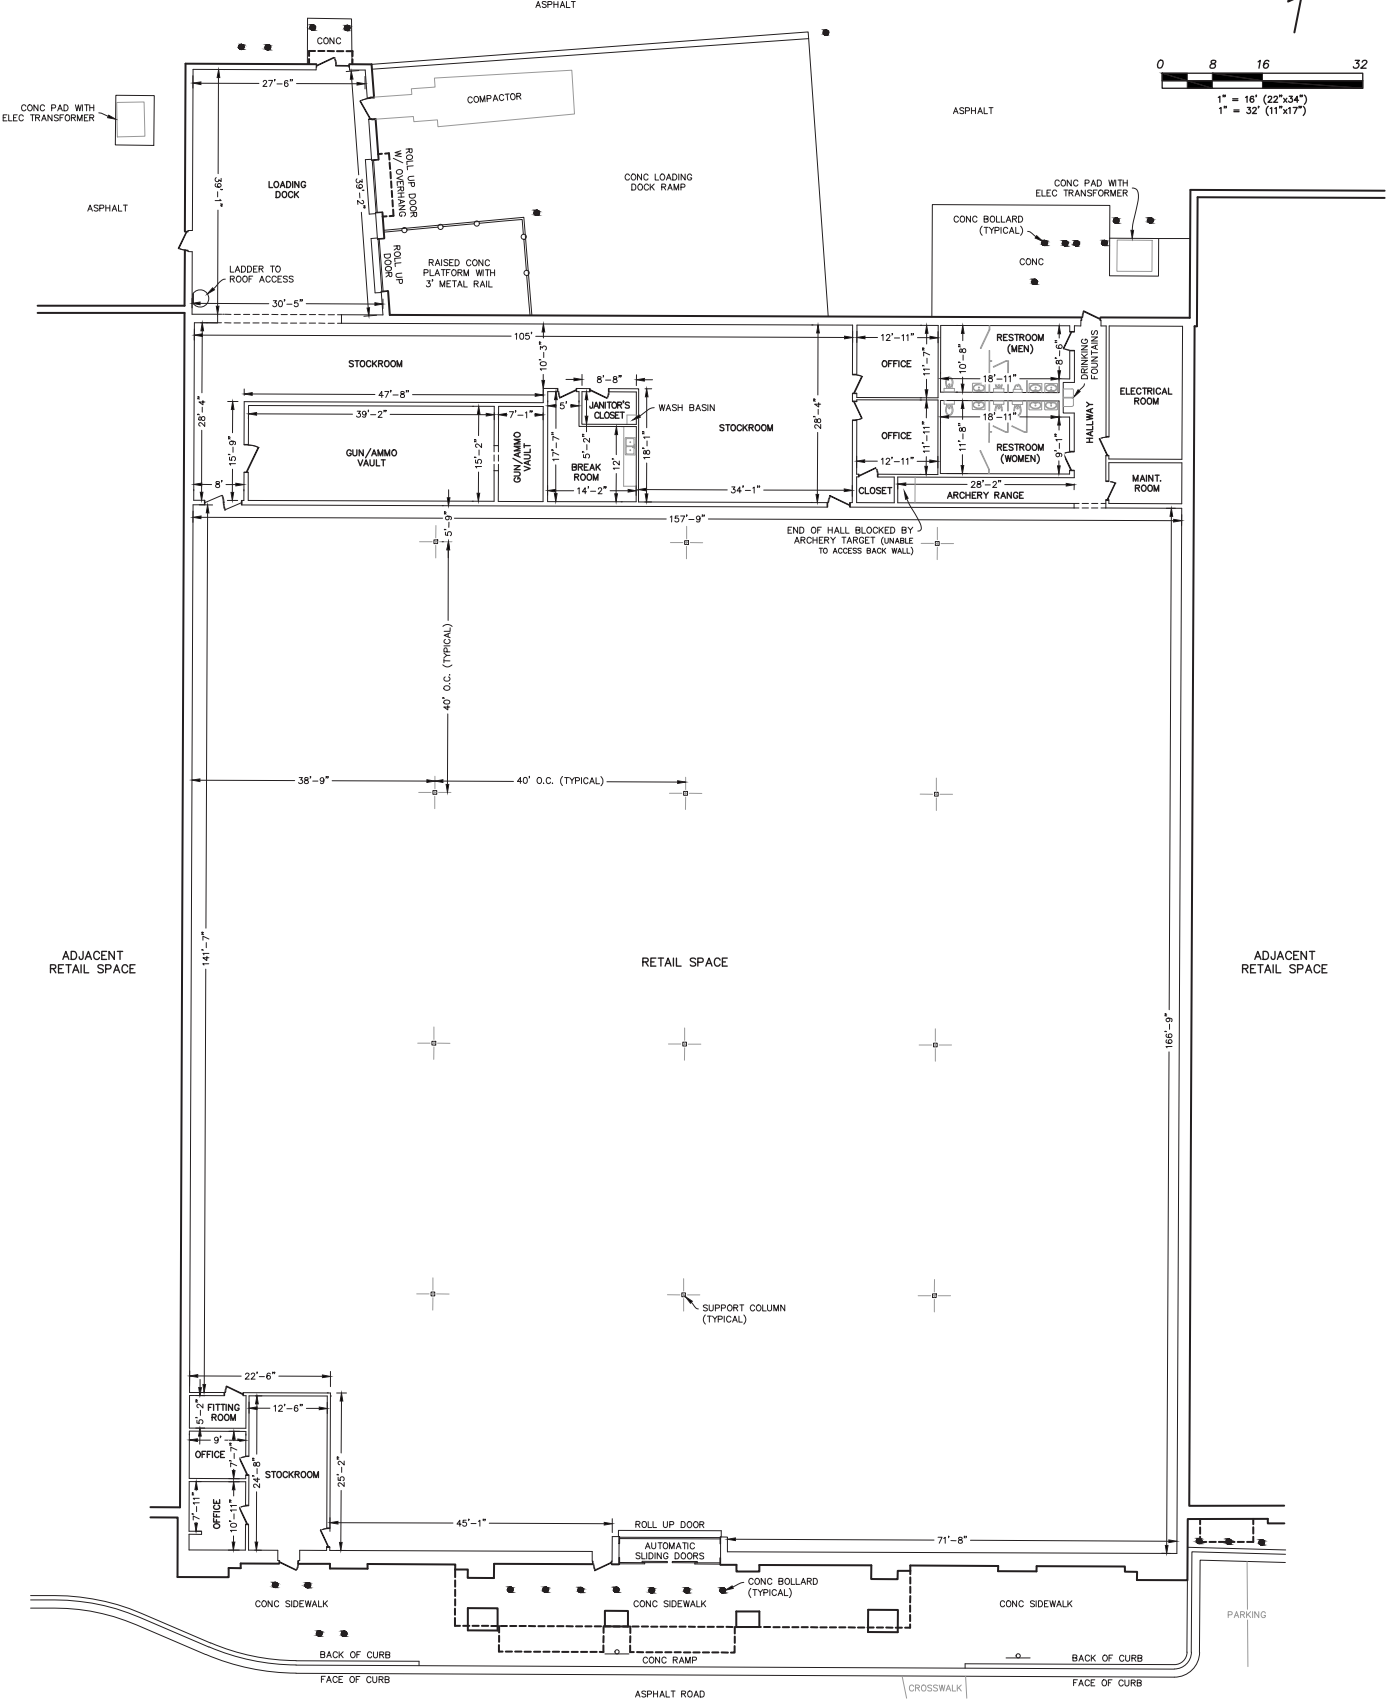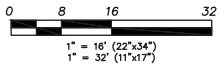

**FLOORPLAN - ASBUILT**  
 (32,041 SQUARE FEET, MOL)  
 SCALE: 1" = 16' (22"x34")  
 SCALE: 1" = 32' (11"x17")